


#2710
VACANT
875 USF
1011 RSF



27TH FLOOR

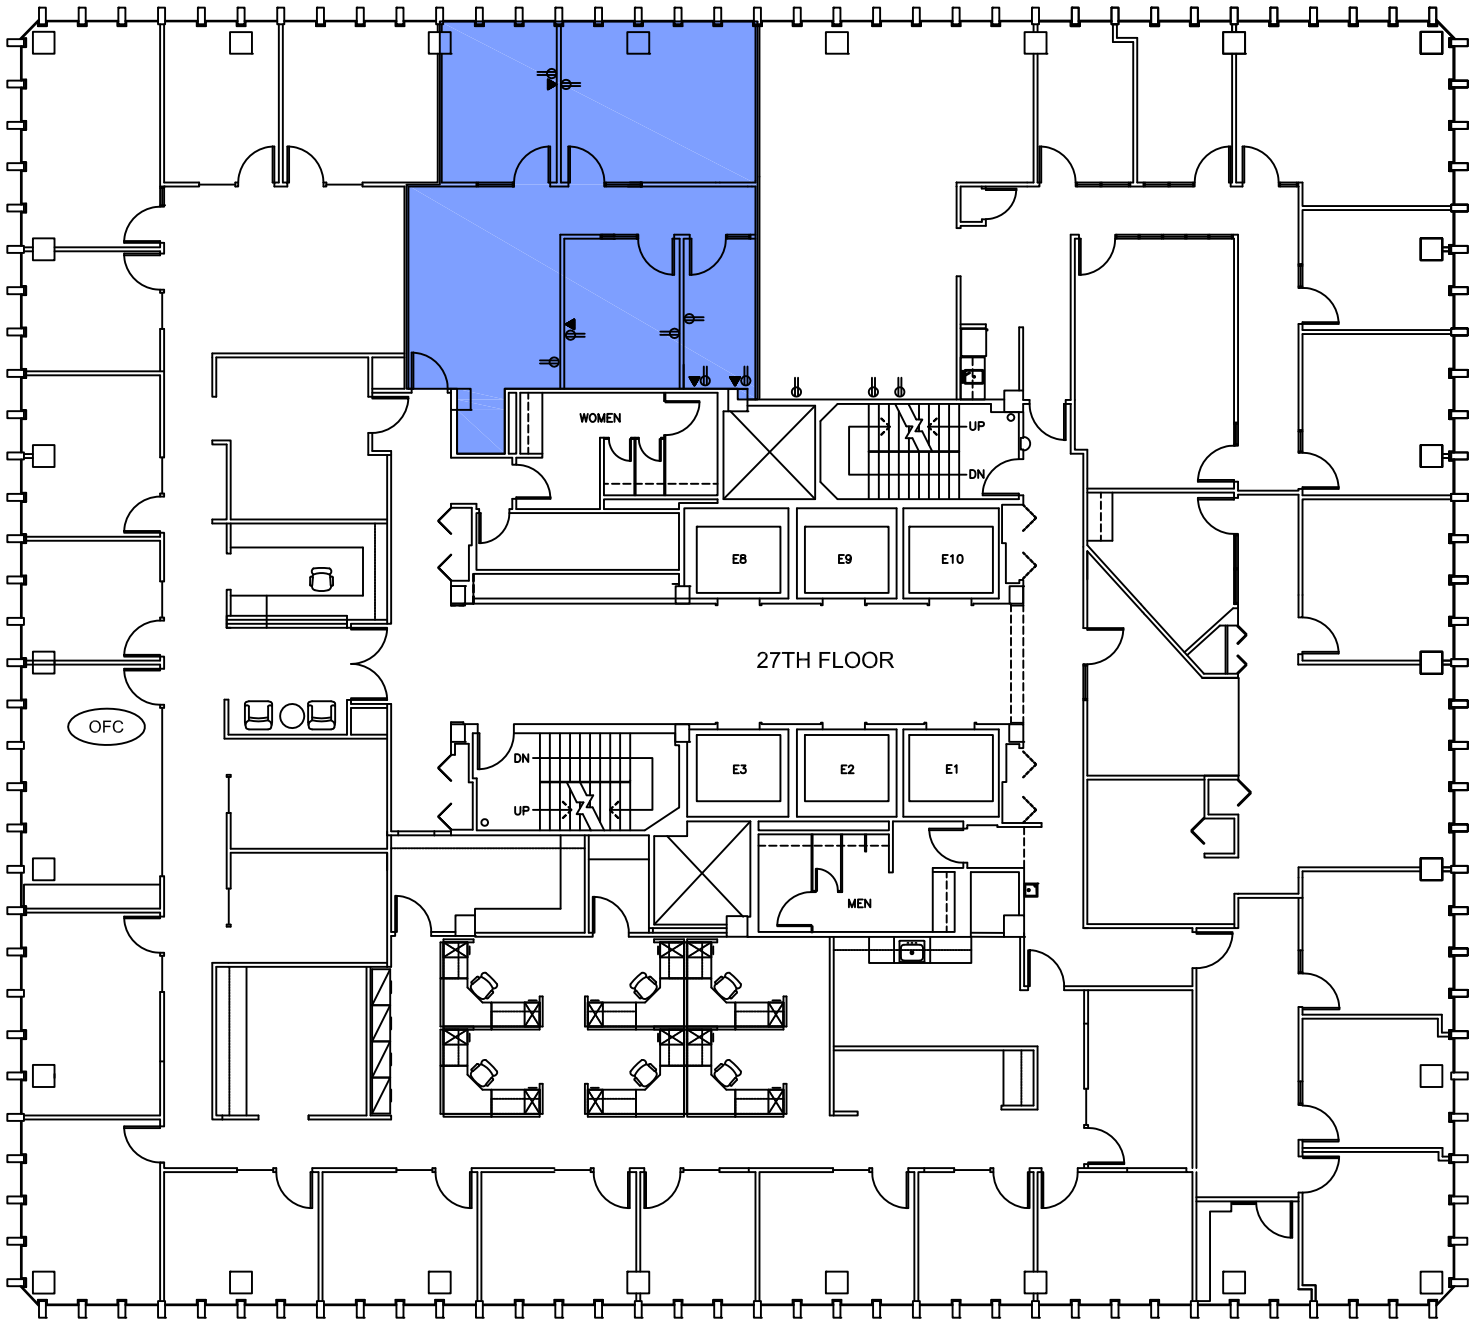

THE WESTIN BUILDING
2001 SIXTH LLC

27th FLOOR
AS-BUILT FLOOR PLAN
NOT TO SCALE

